




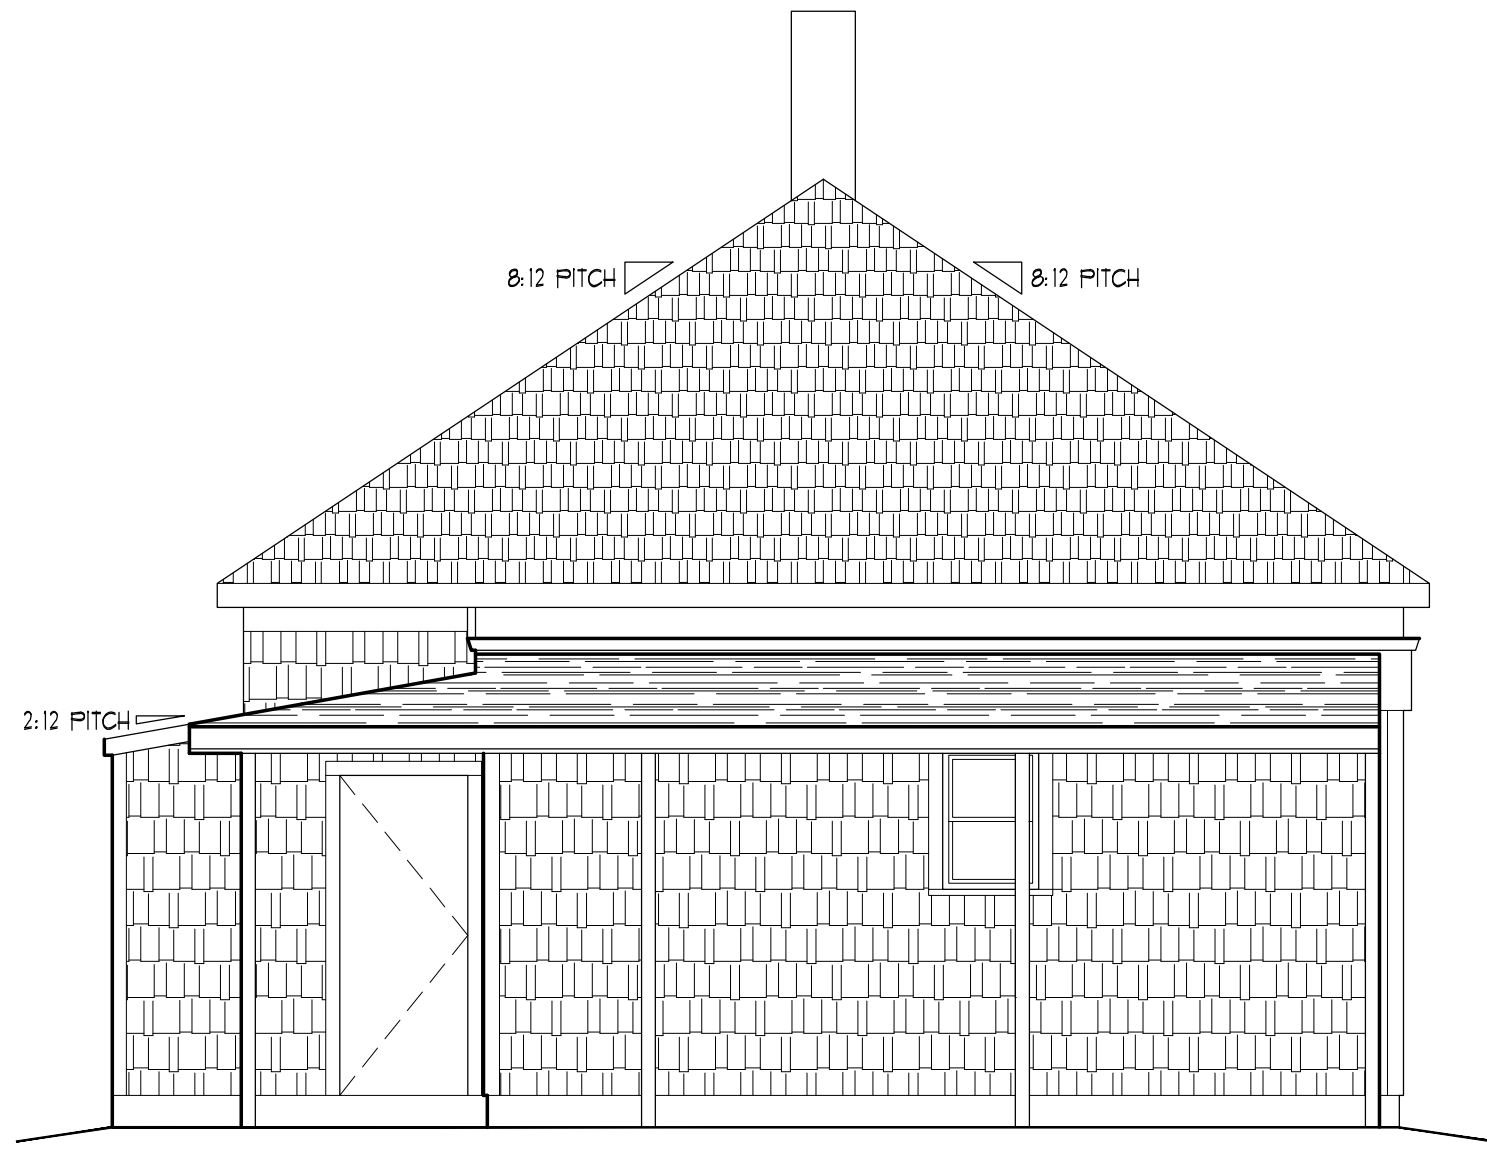


3 EXISTING BACK ELEVATION (NORTH)
1/4" = 1'-0"

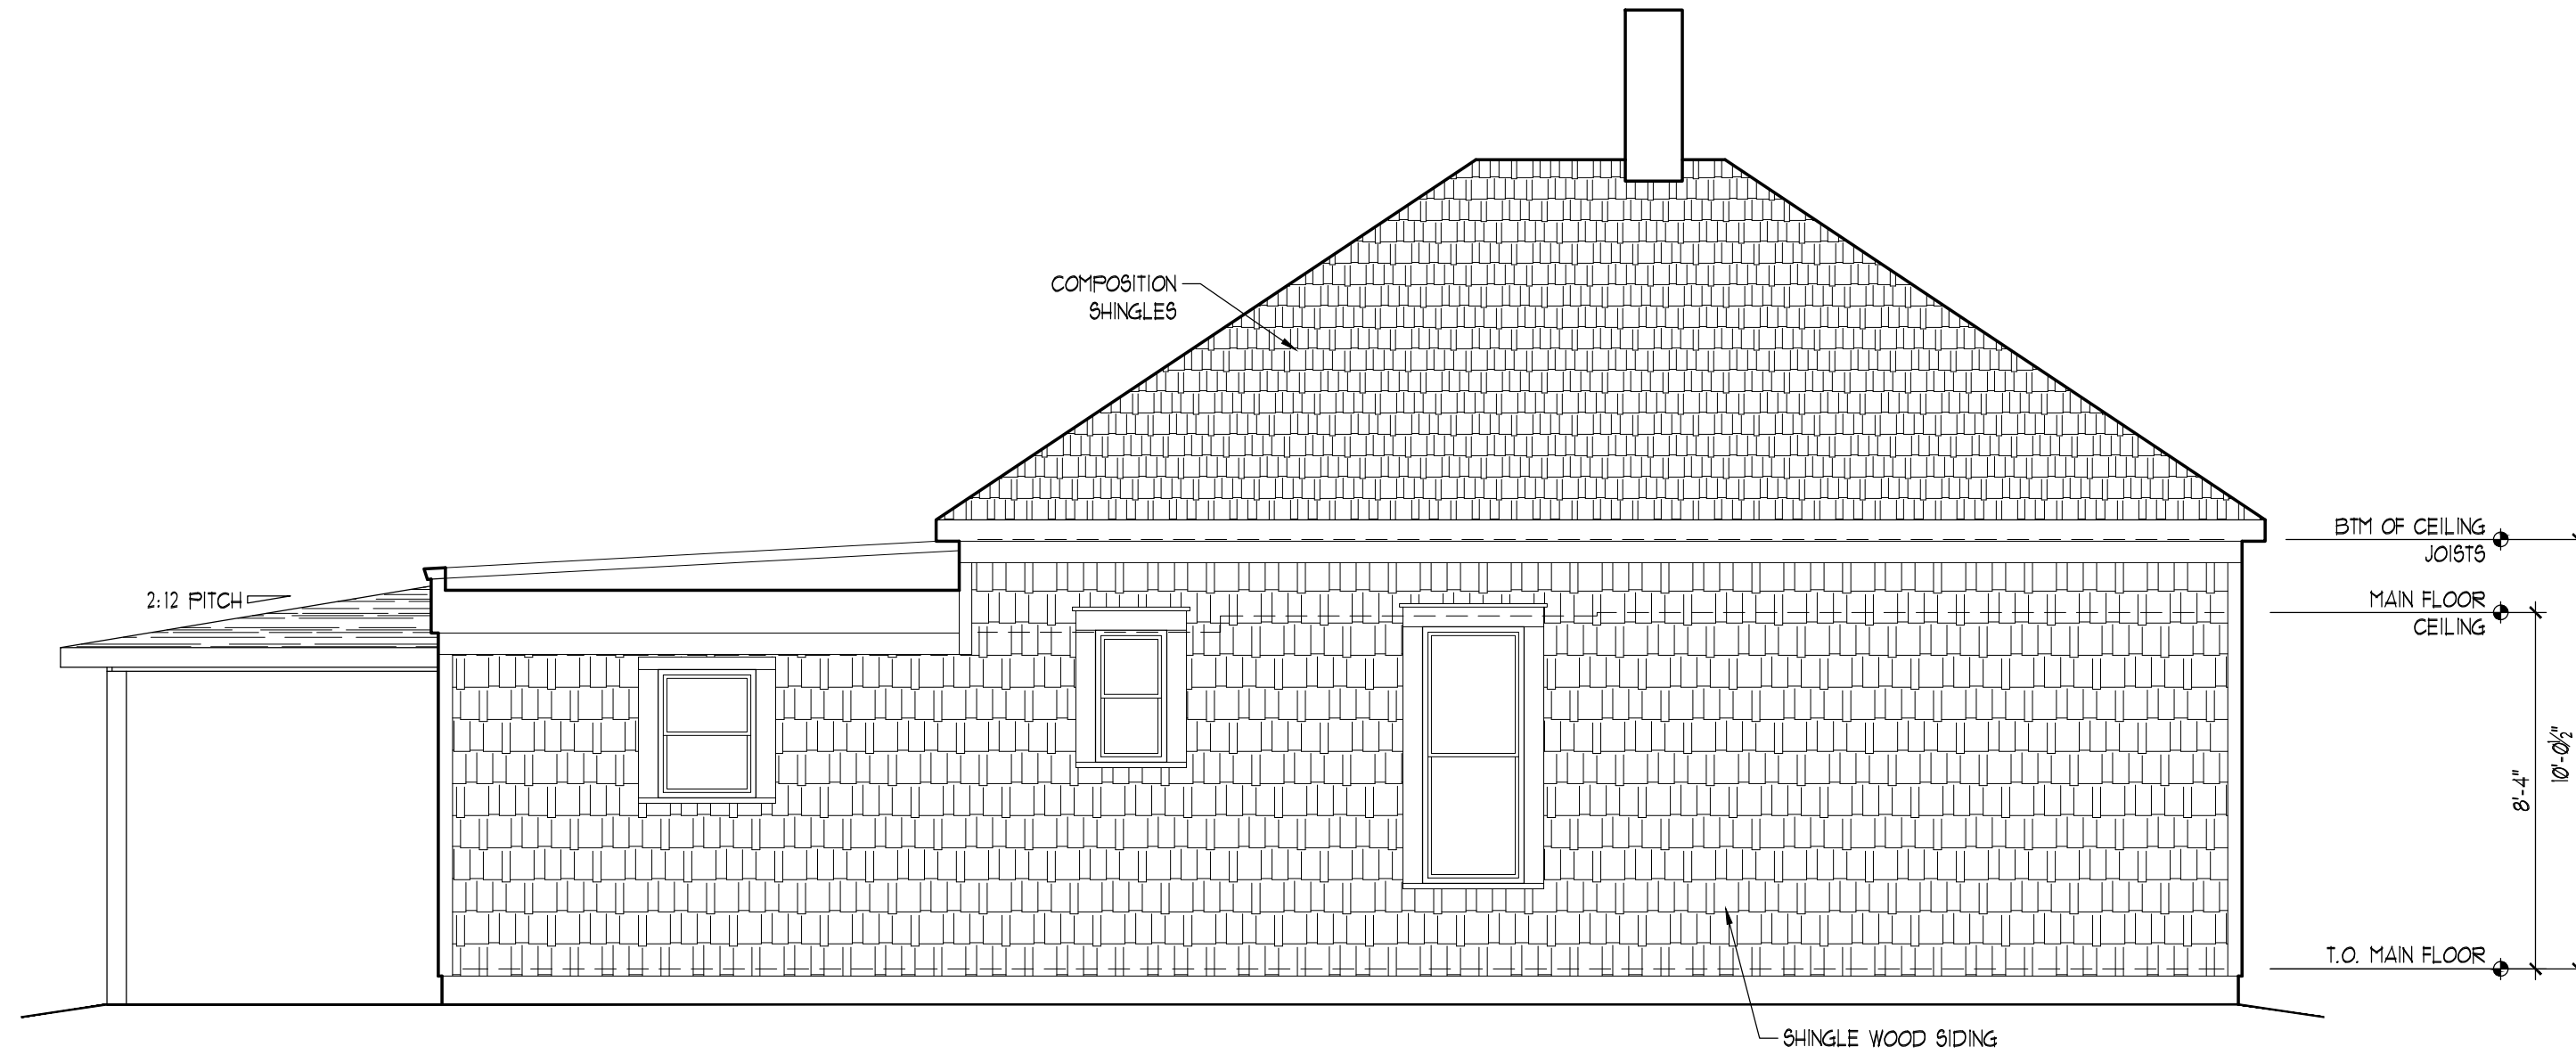

4 EXISTING LEFT ELEVATION (WEST)
1/4" = 1'-0"

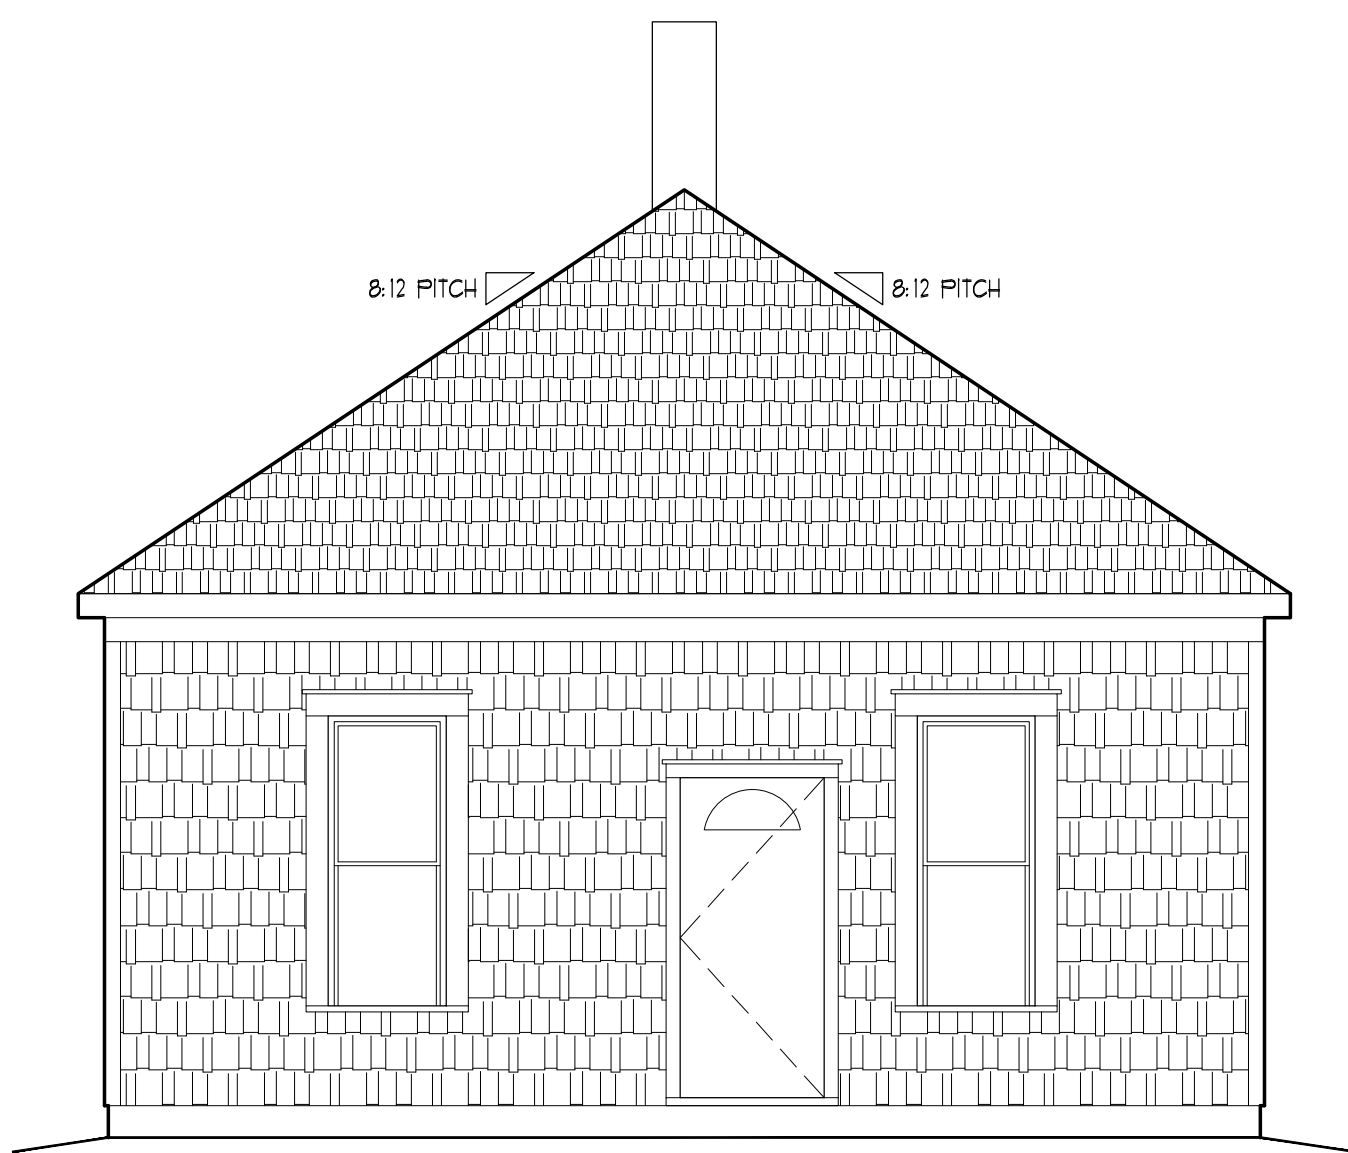

1 EXISTING FRONT ELEVATION (SOUTH)
1/4" = 1'-0"

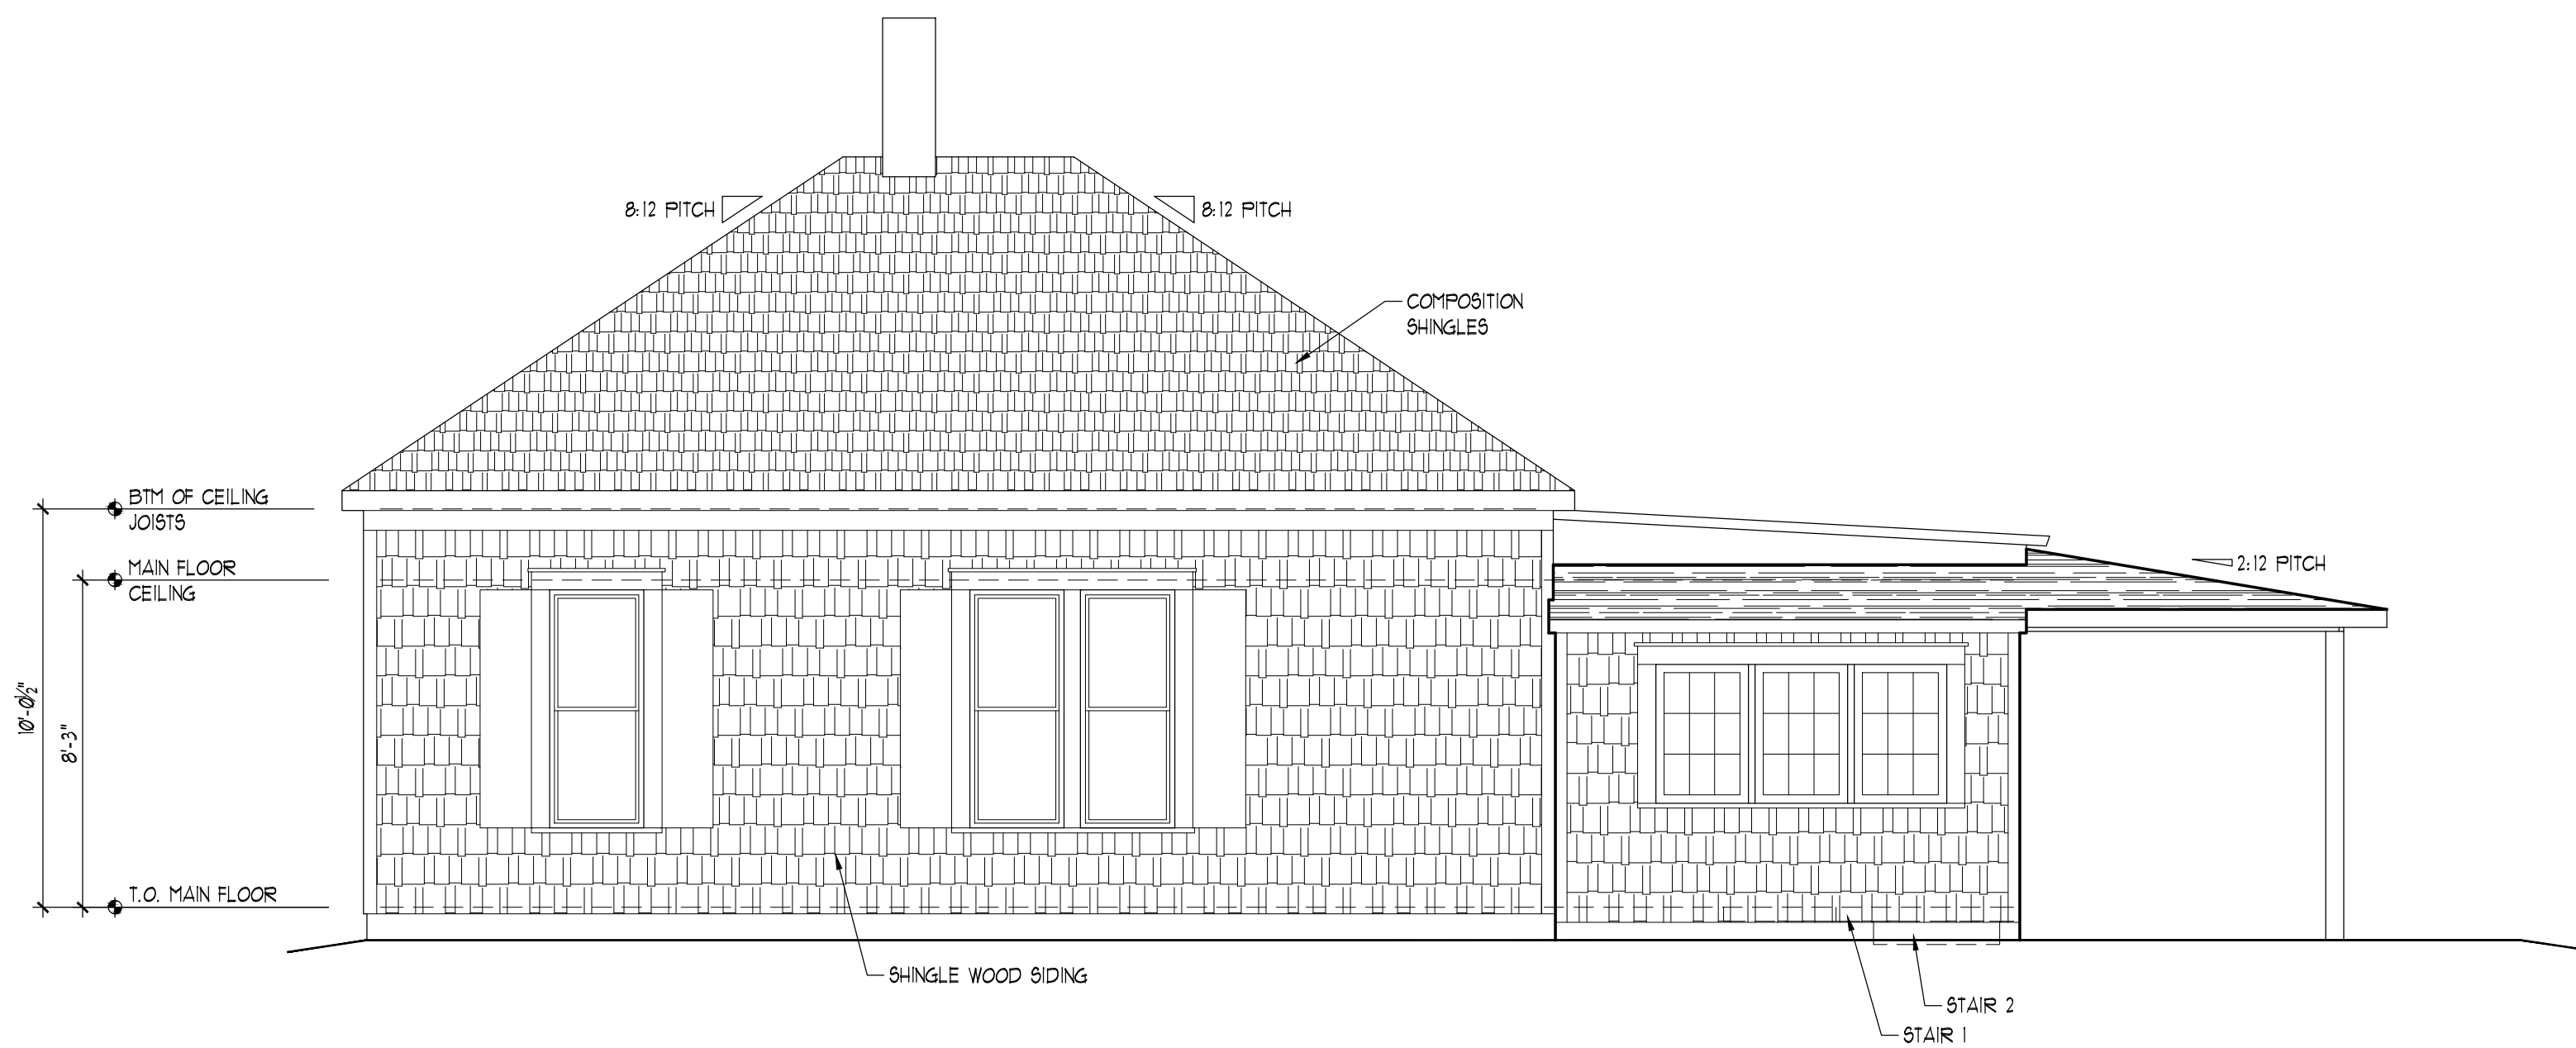

2 EXISTING RIGHT ELEVATION (EAST)
1/4" = 1'-0"

AS-BUILT PLANS FOR THE
CONKLING RESIDENCE
2202 WEST KIOWA STREET
COLORADO SPRINGS, COLORADO 80904

ISSUE DATE	5.27.2025
REVISED	—
REVISED	—
REVISED	—

AS-BUILT
PLANS
A3.0

ON POINT DRAFTING SERVICES
OZIEL 'OZZY' PALACIOS
COLORADO SPRINGS, COLORADO 80910
onpointdraftingservices@gmail.com