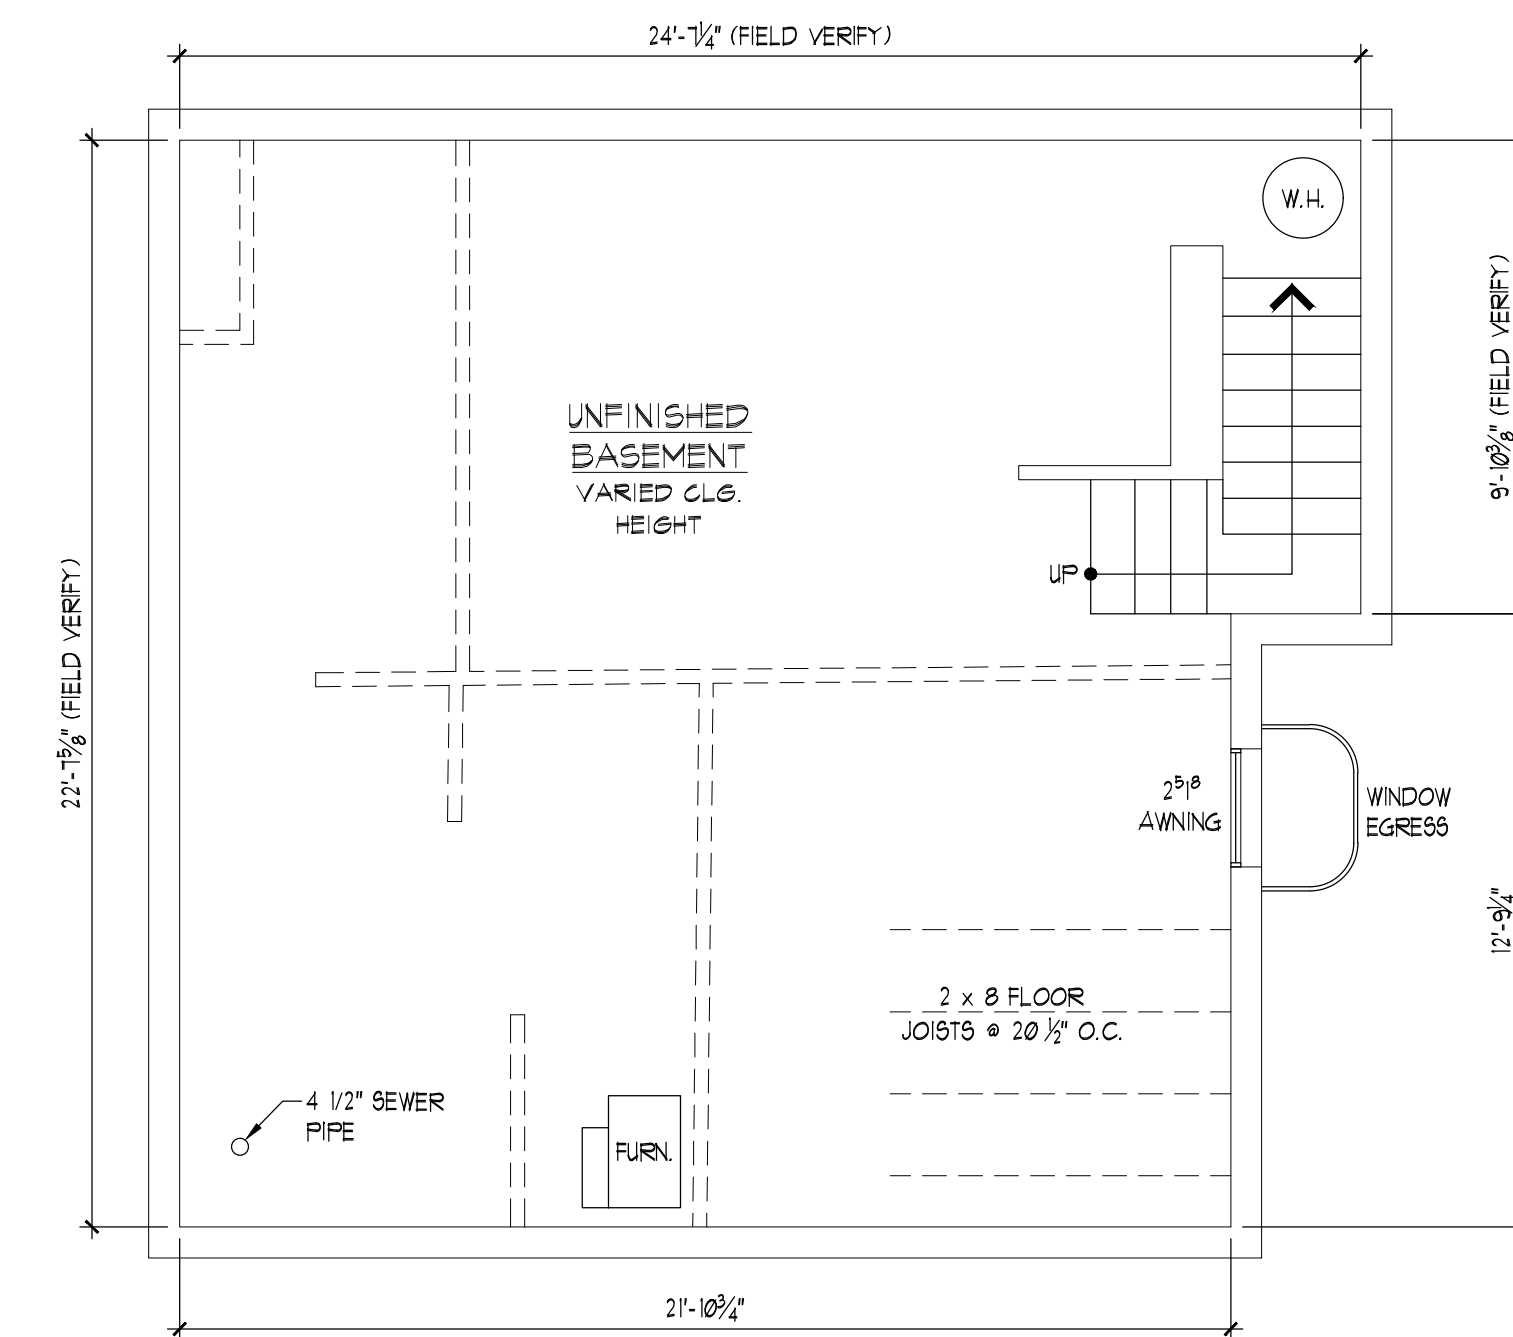
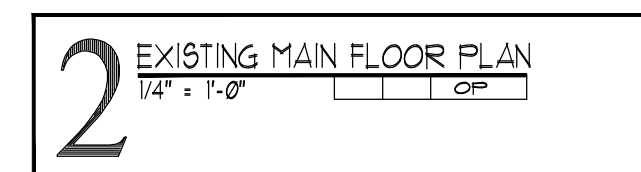
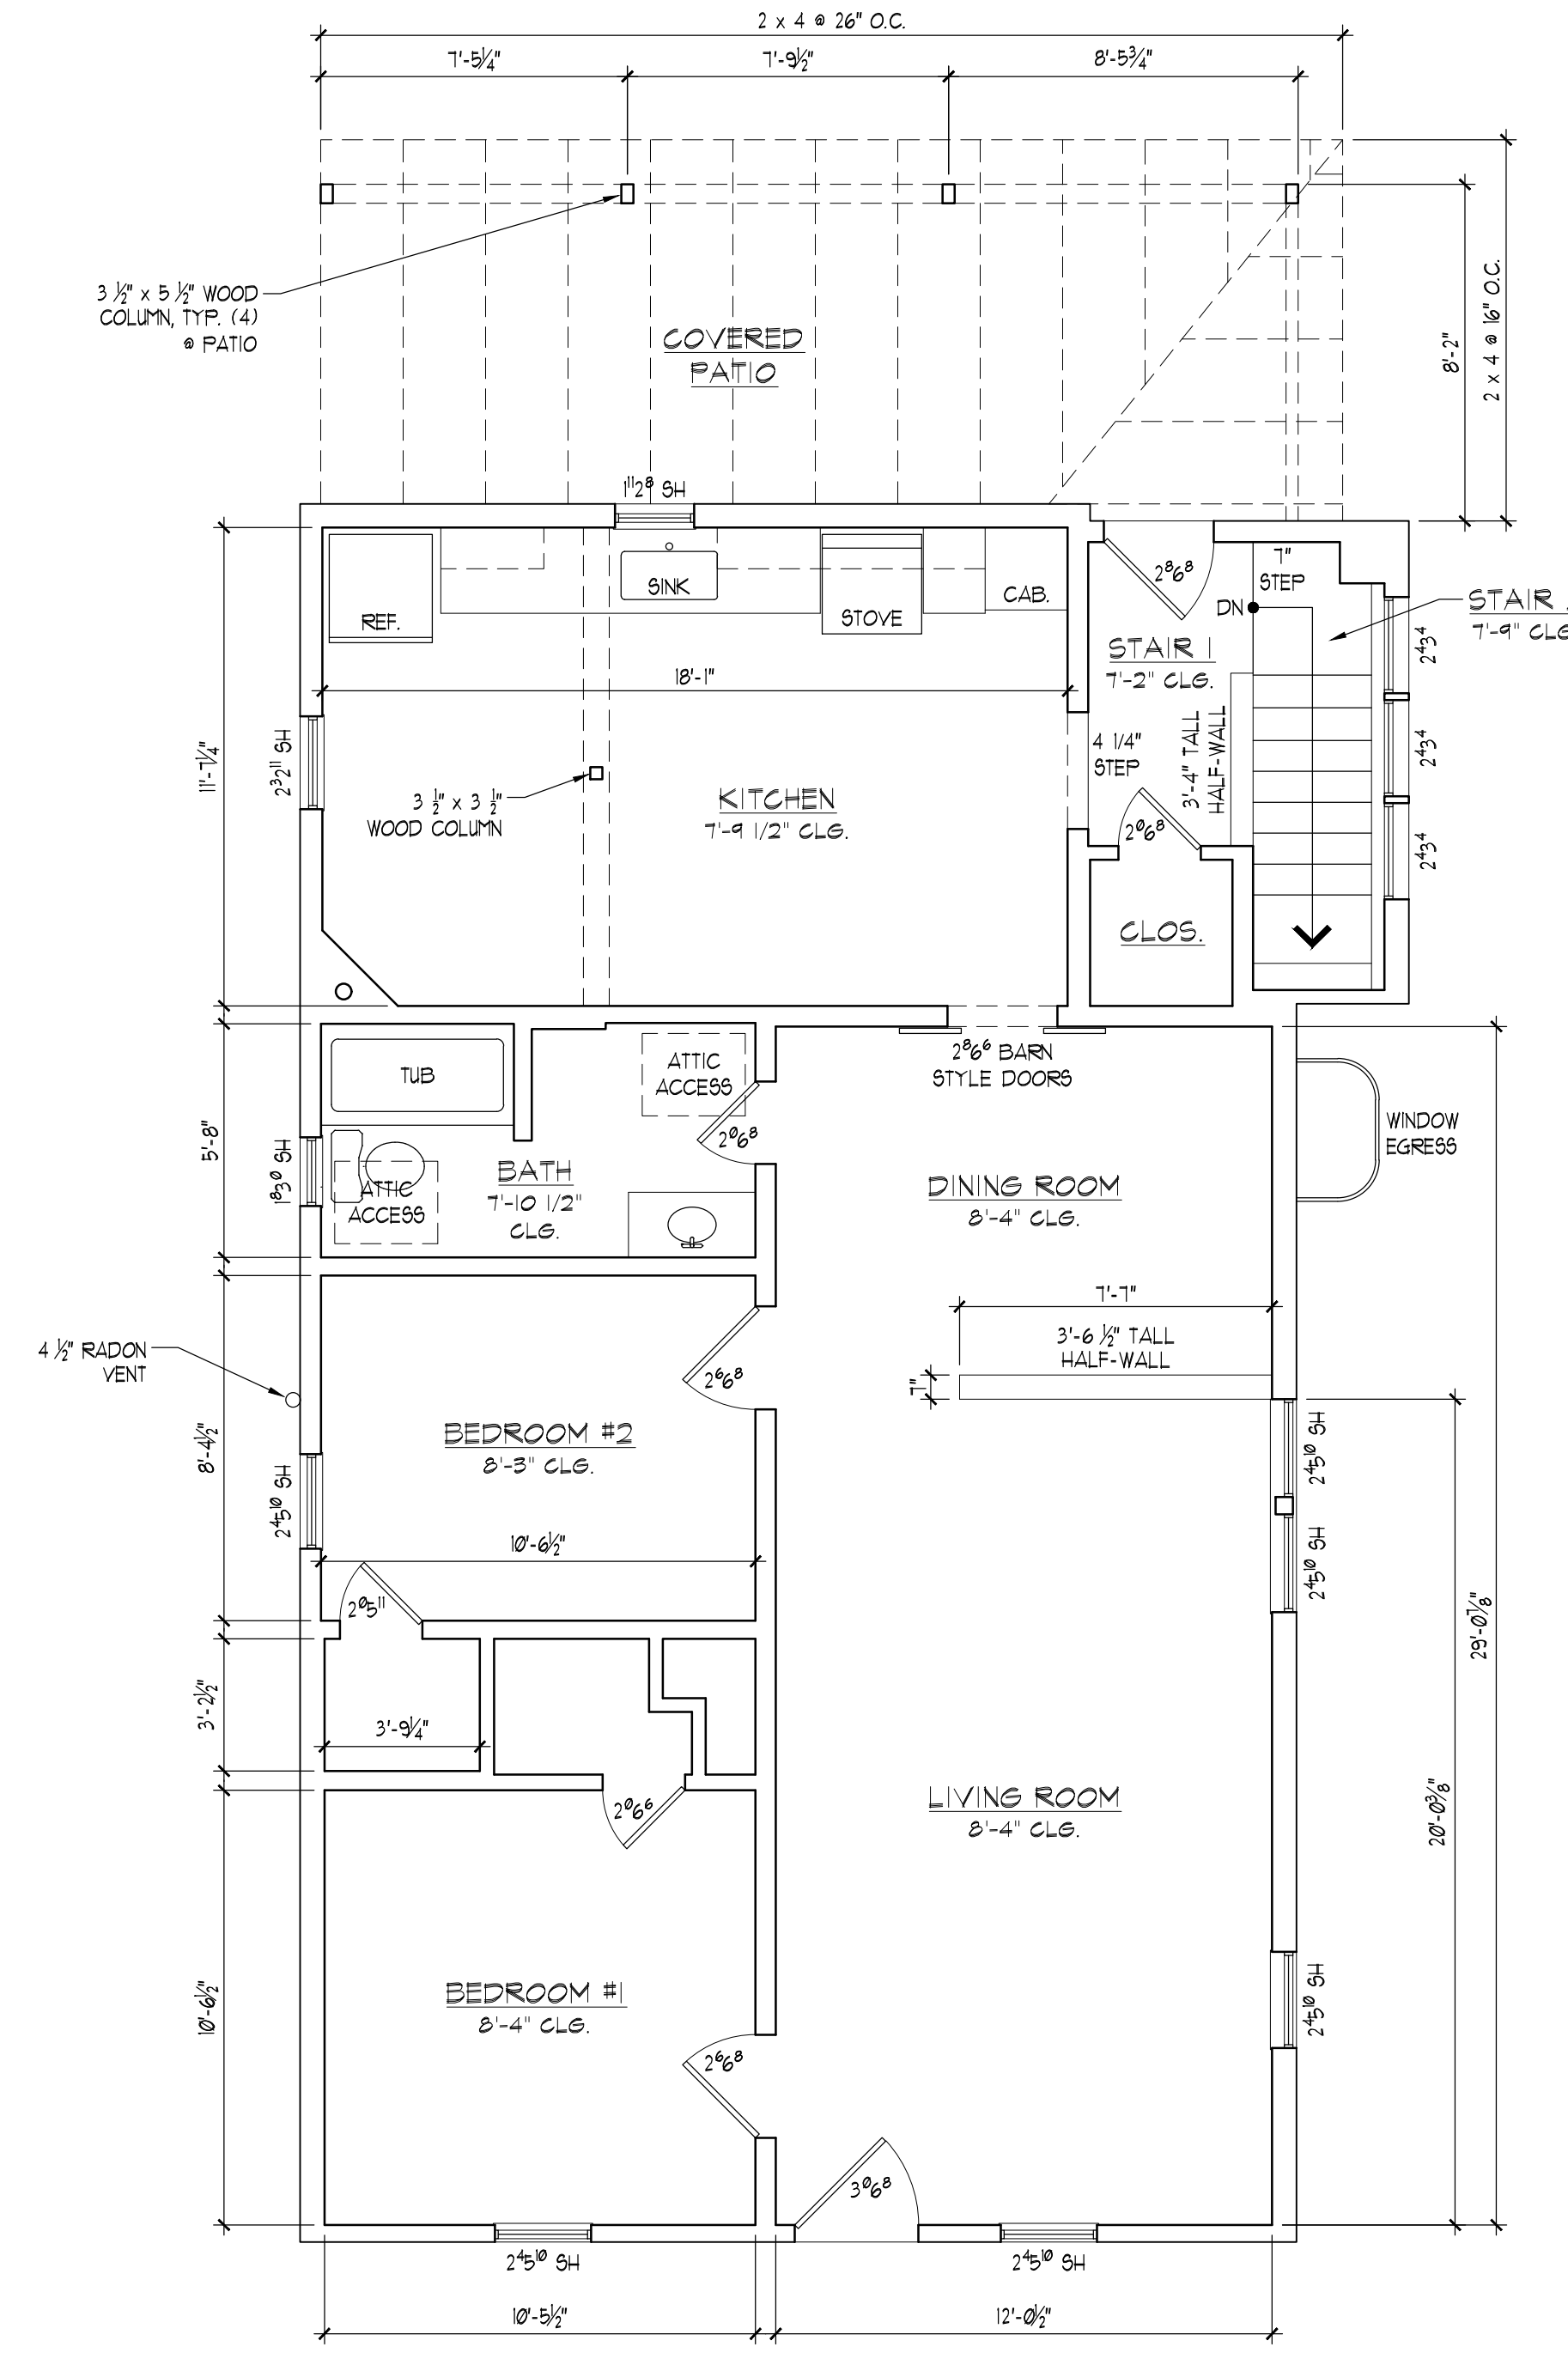
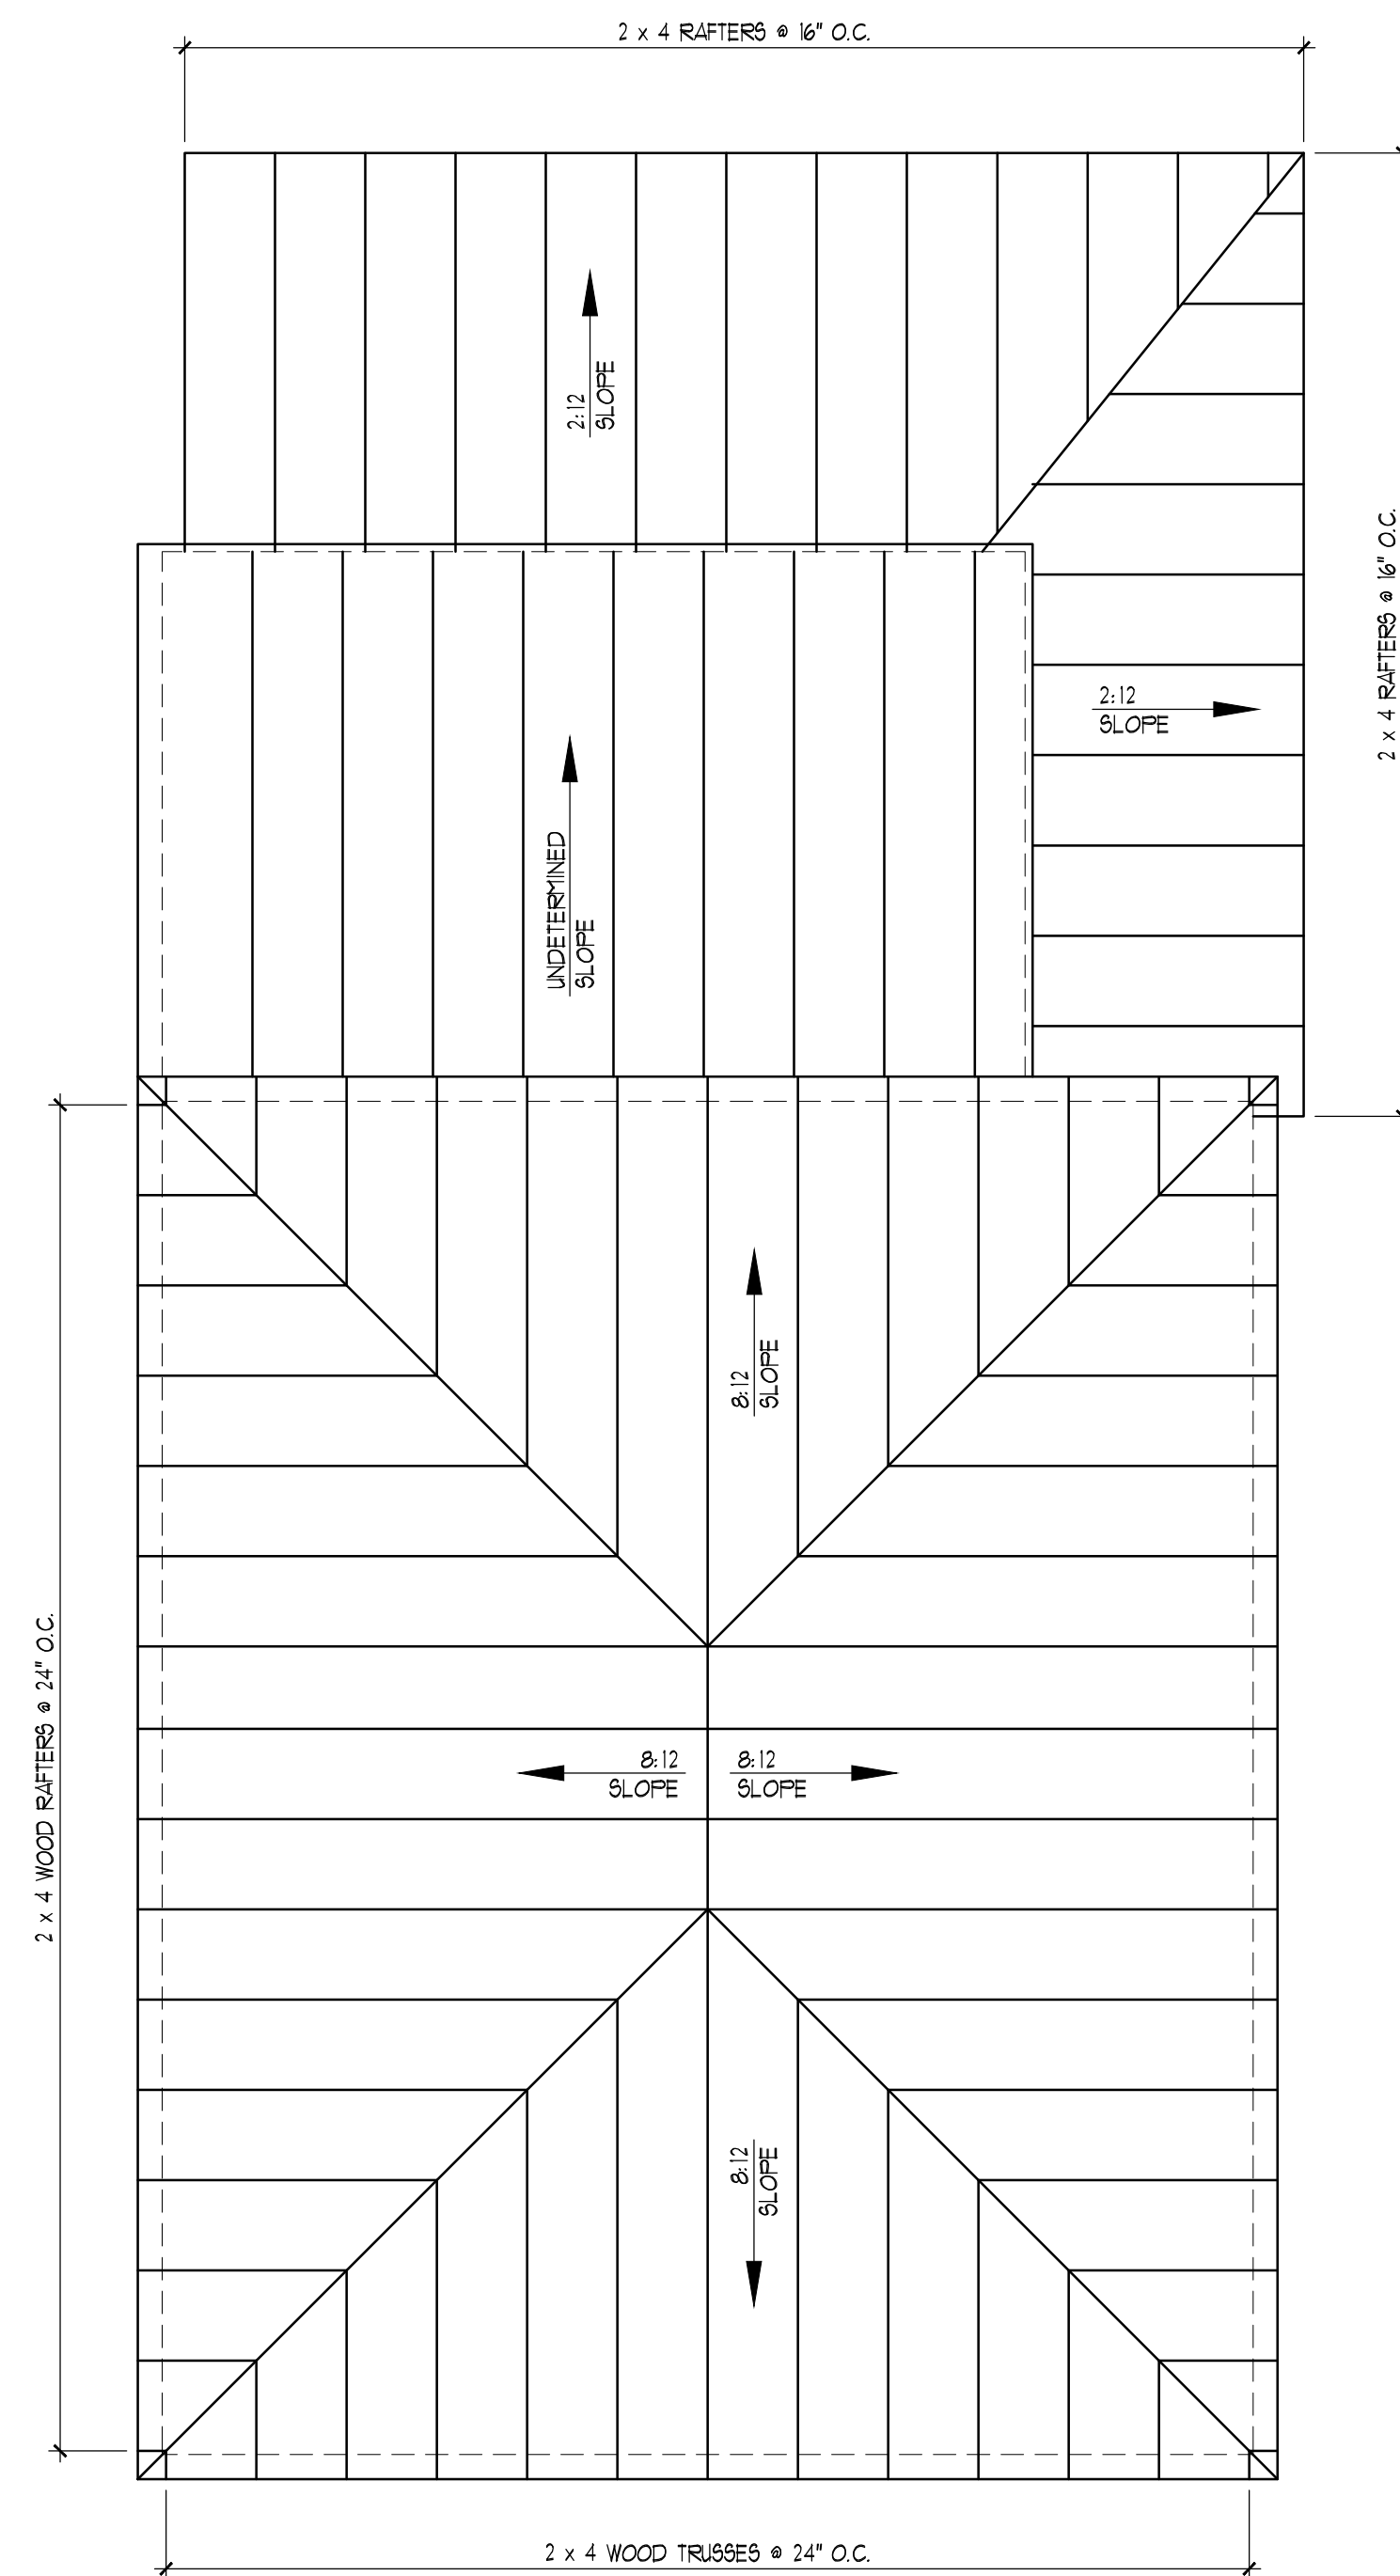


**AS-BUILT PLANS FOR THE
CONKLING RESIDENCE**
2202 WEST KIOWA STREET
COLORADO SPRINGS, COLORADO 80904

ON POINT DRAFTING SERVICES
OZIEL 'OZZY' PALACIOS
COLORADO SPRINGS, COLORADO 80910
onpointdraftingservices@gmail.com

ISSUE DATE	5.27.2025
REVISED	
REVISED	—
REVISED	—

**AS-BUILT
PLANS**

A2.0

THE USE OF THESE PLANS SHALL BE RESTRICTED TO THE ORIGINAL PROJECT SITE FOR WHICH THEY WERE PREPARED AND PUBLICATION THEREOF IS EXPRESSLY LIMITED TO SUCH USE. REPRODUCTION OR PUBLICATION BY ANY METHOD, IN WHOLE OR PART, IS PROHIBITED.