
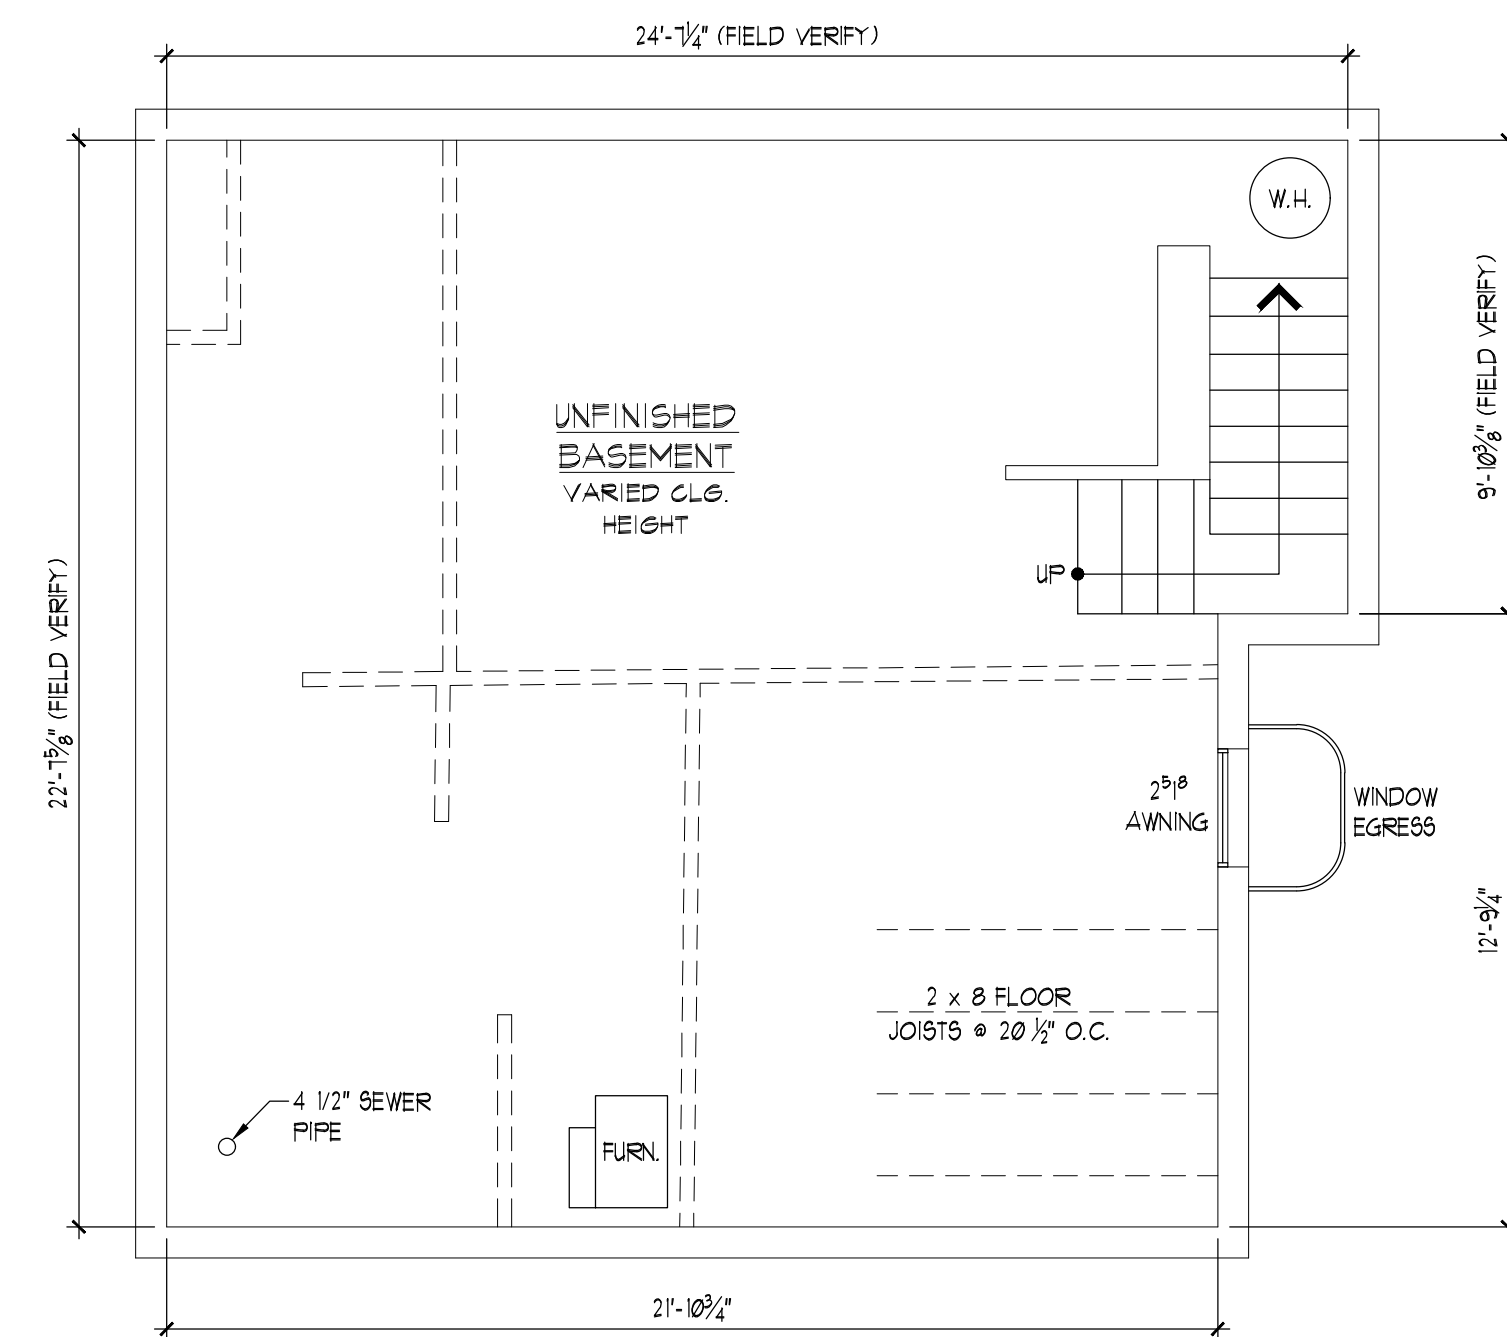
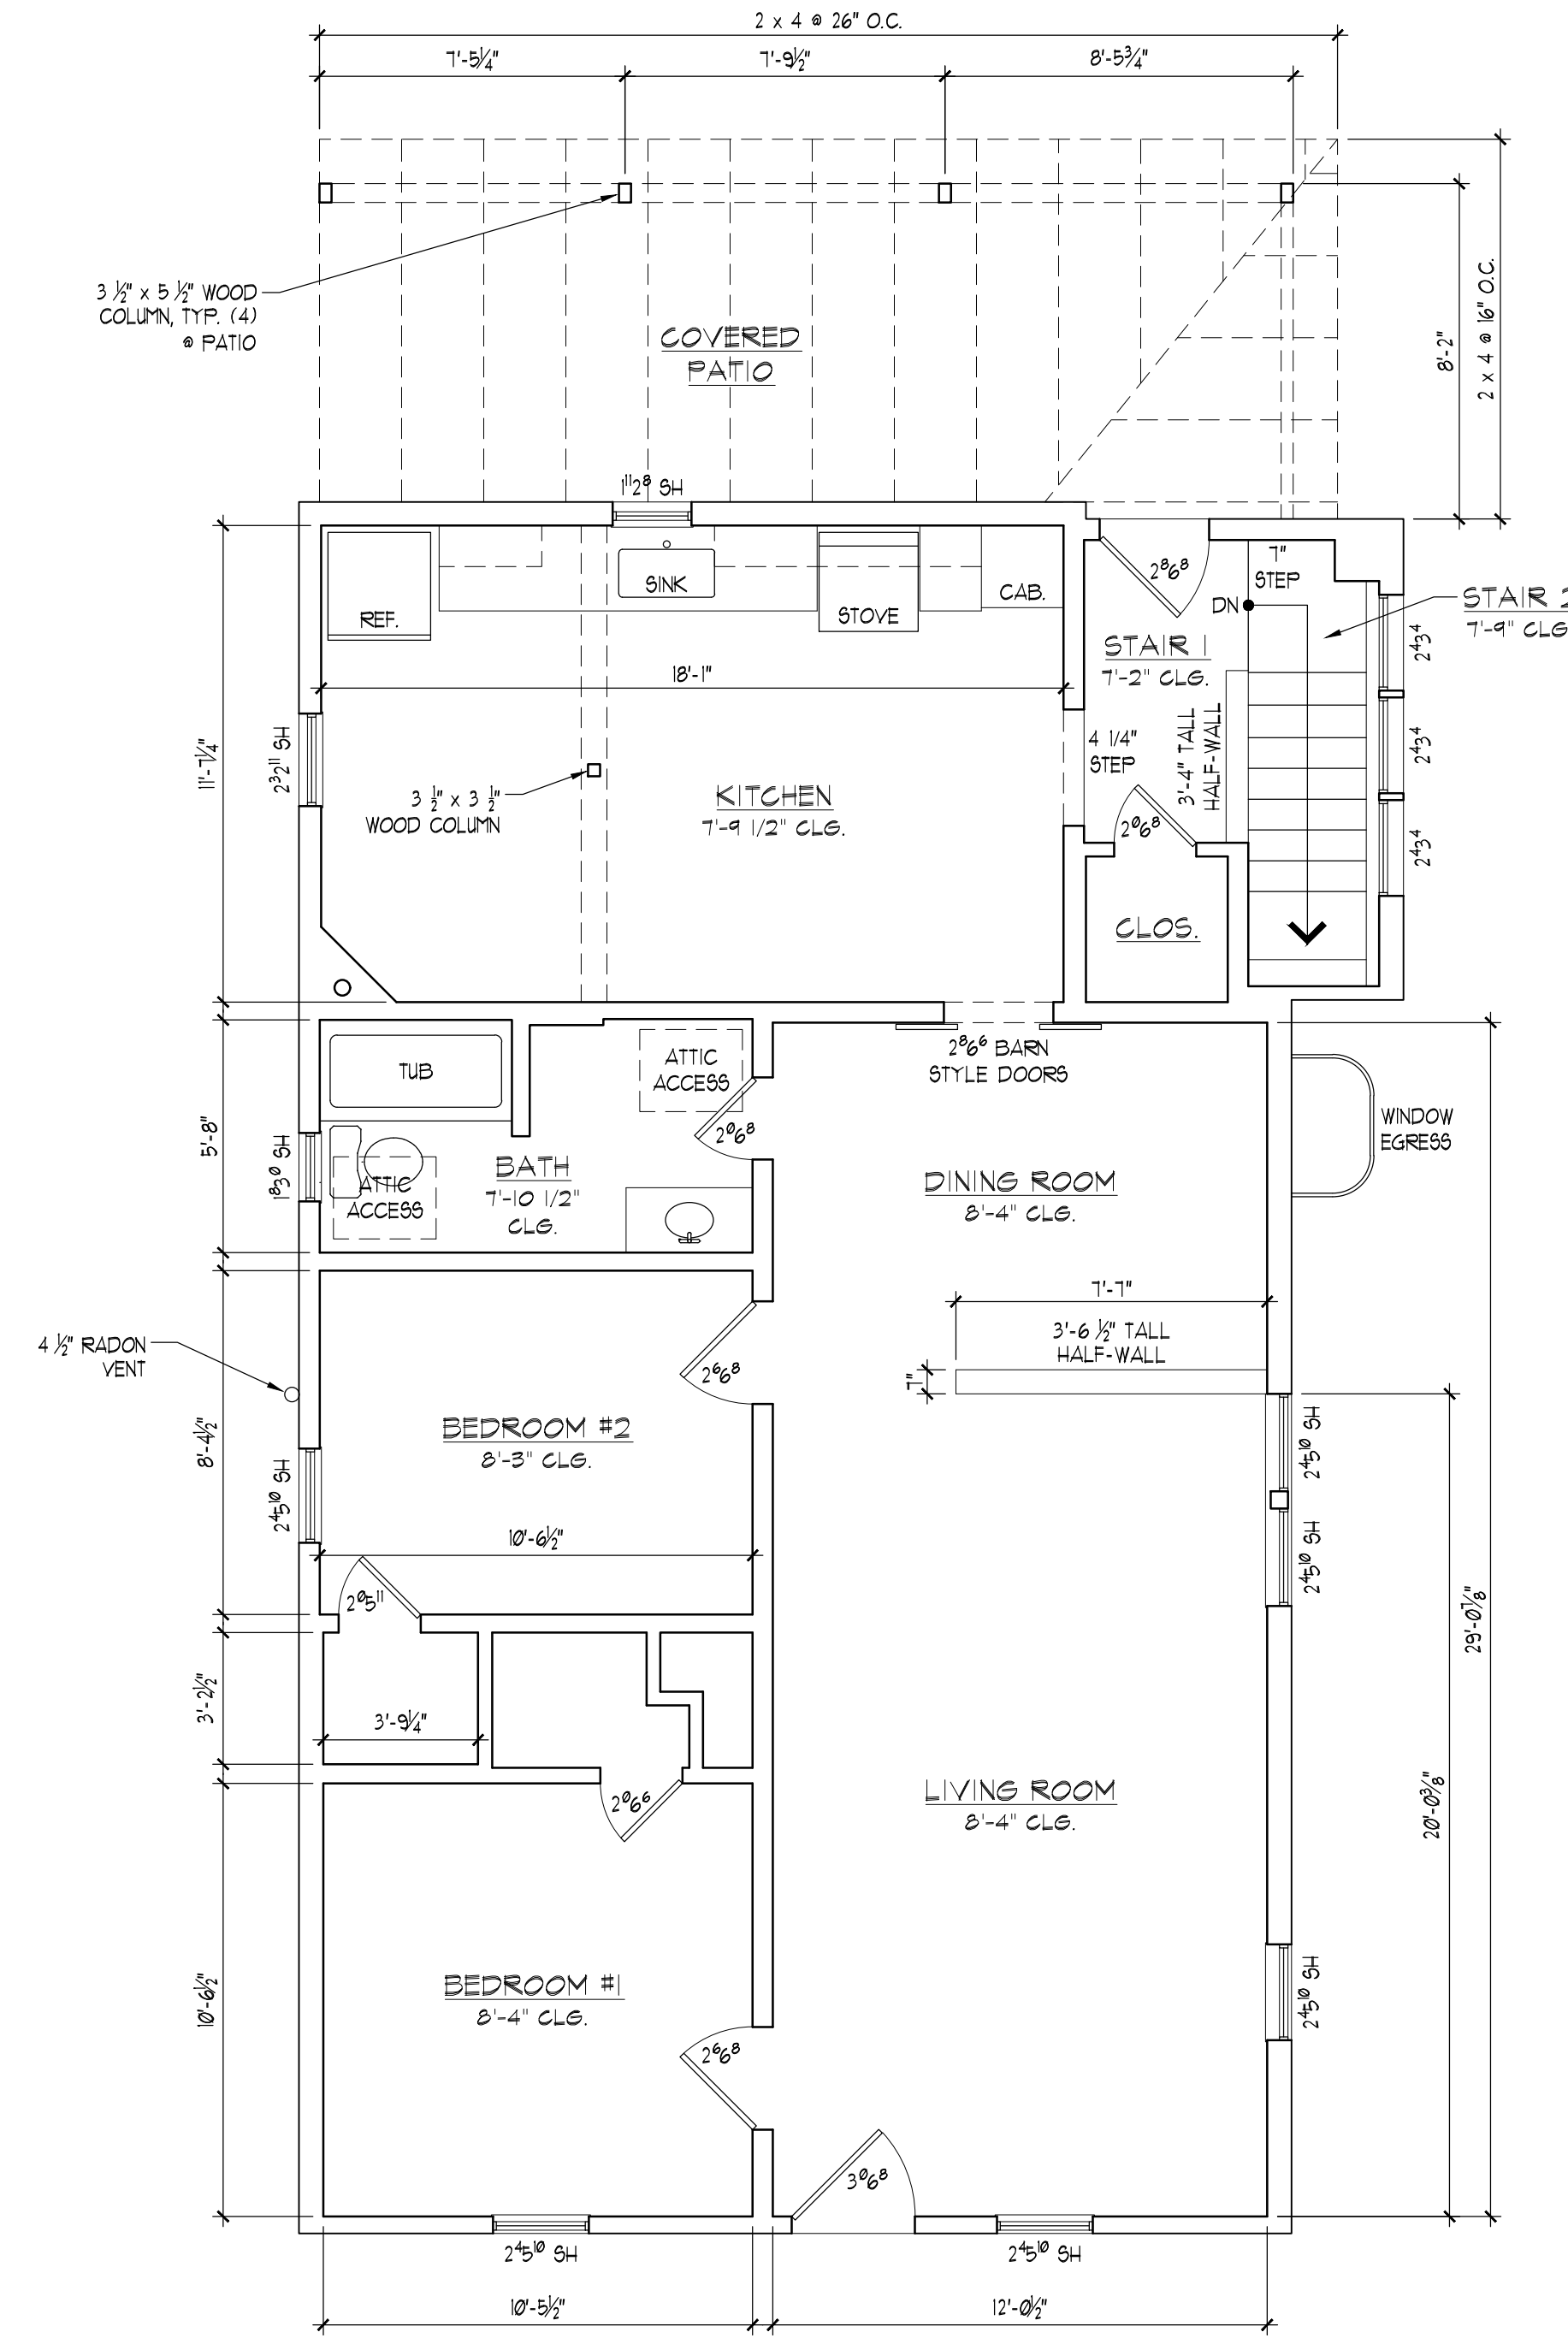


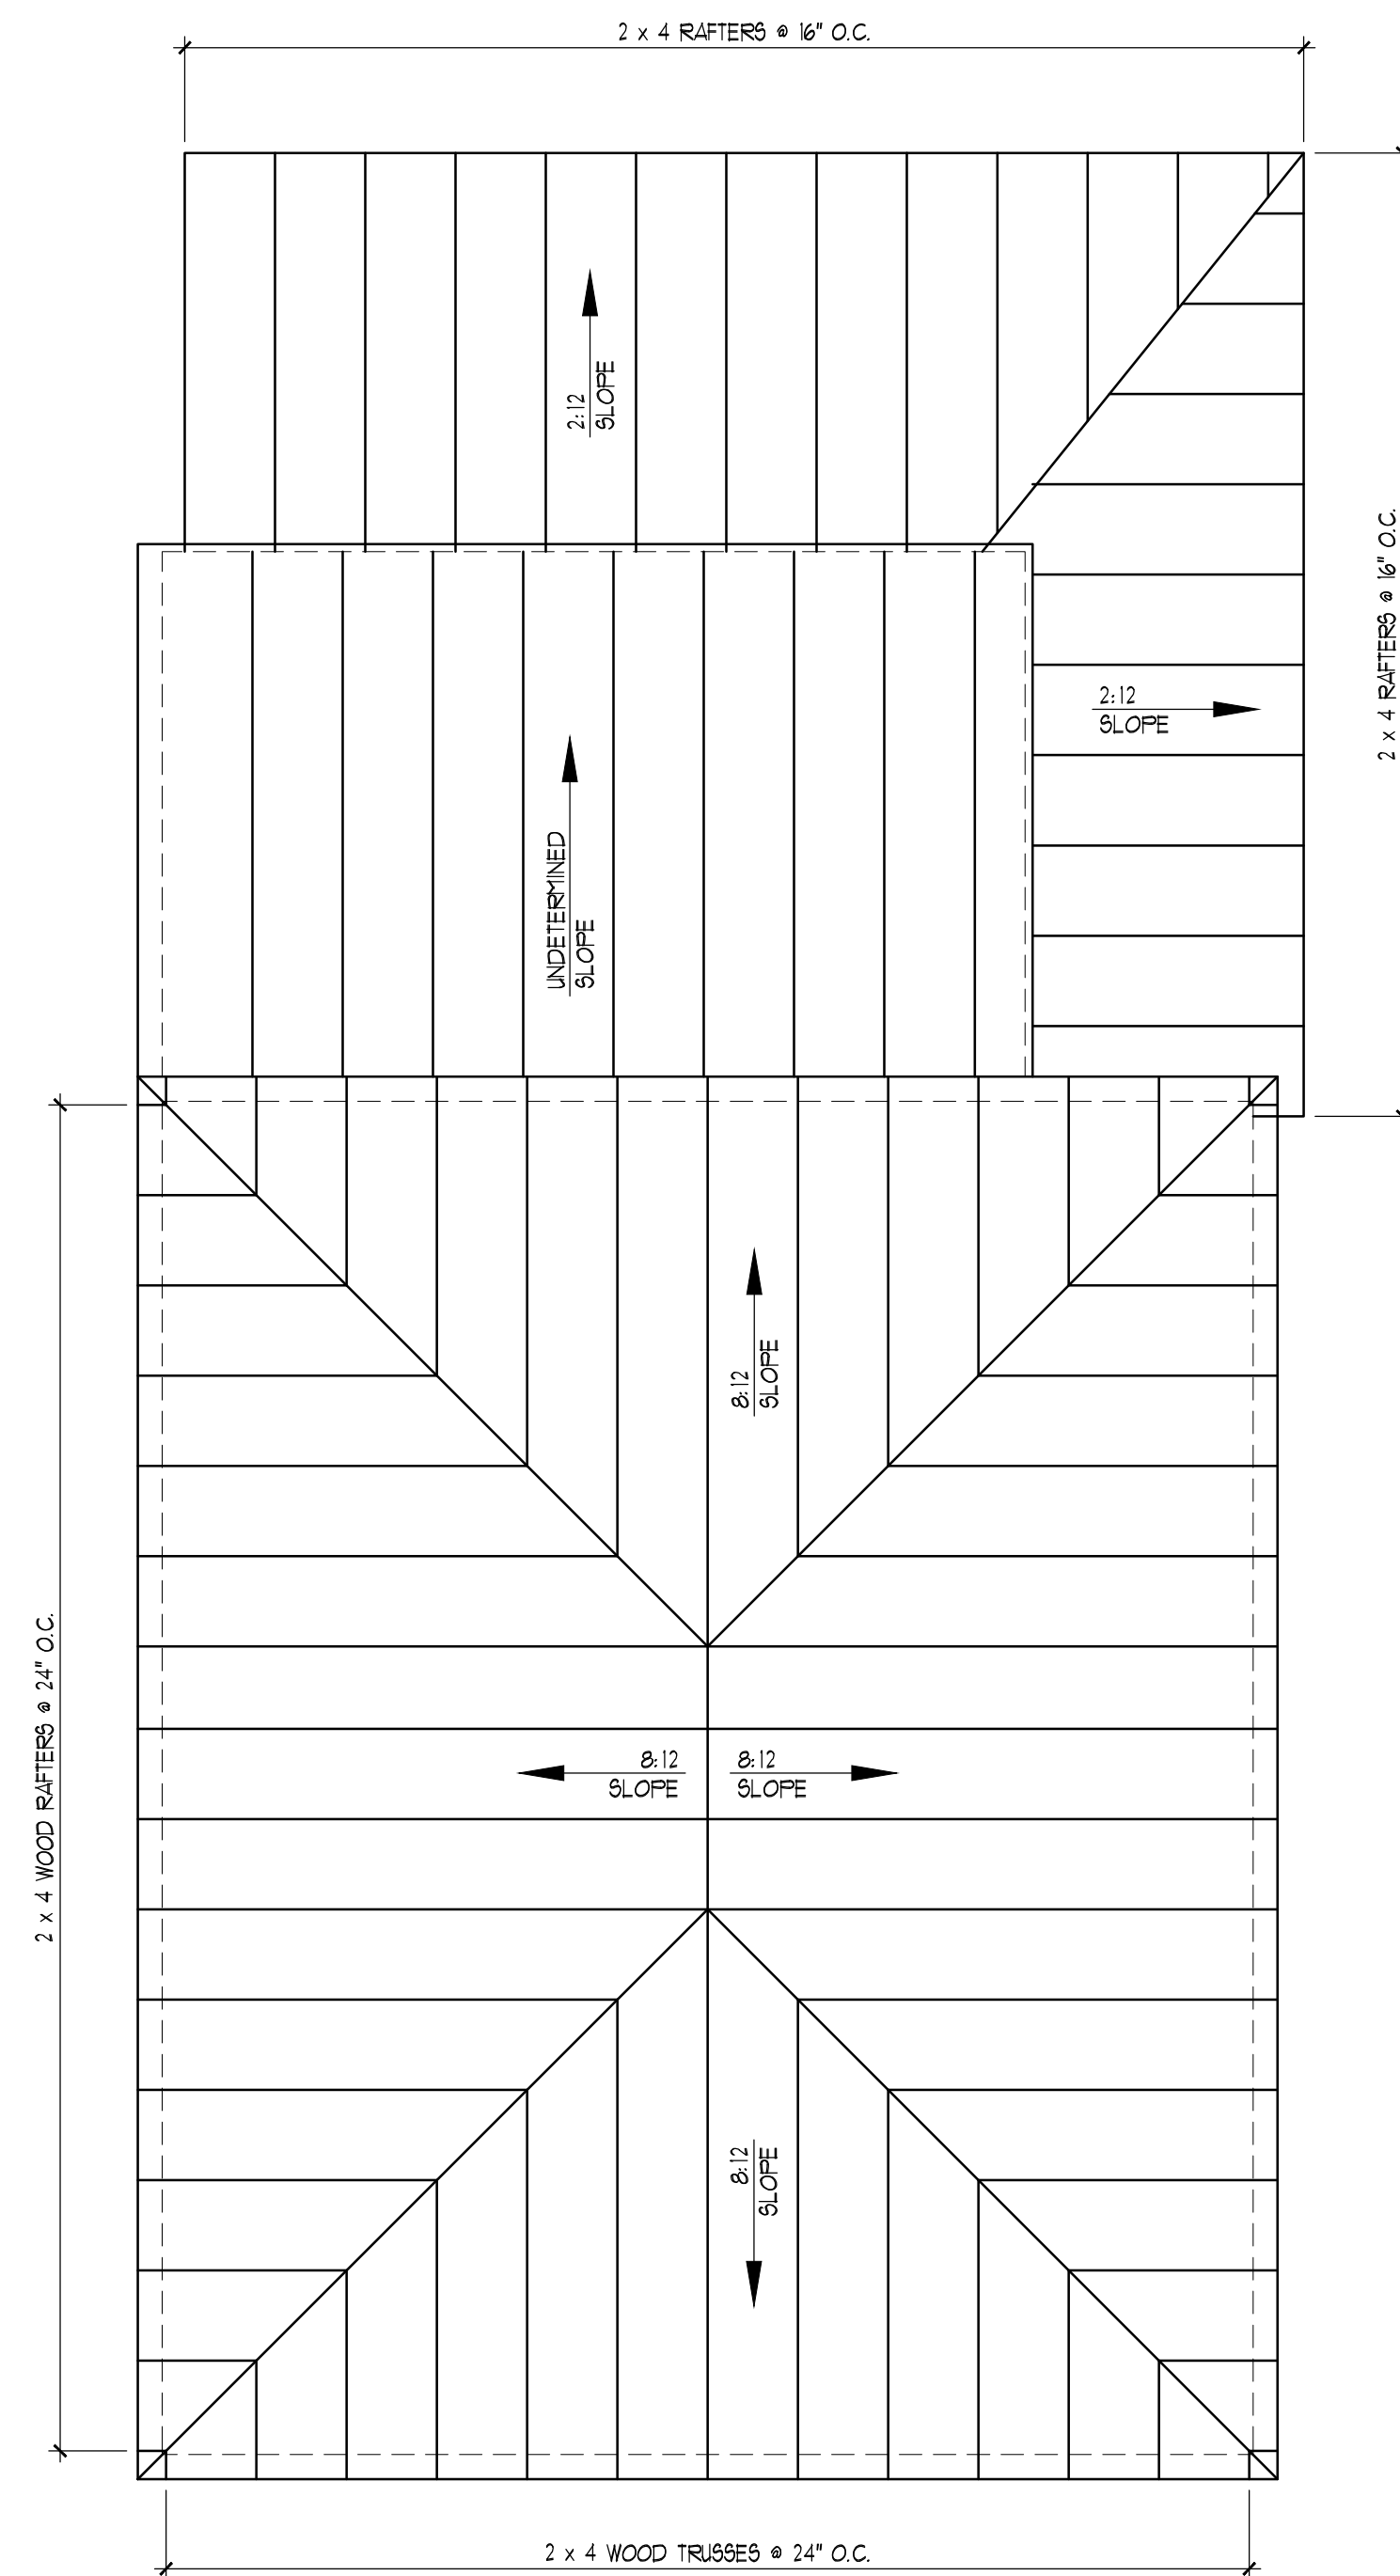

**AS-BUILT PLANS FOR THE
CONKLING RESIDENCE**
2202 WEST KIOWA STREET
COLORADO SPRINGS, COLORADO 80904

ON POINT DRAFTING SERVICES
OZIEL 'OZZY' PALACIOS
COLORADO SPRINGS, COLORADO 80910
onpointdraftingservices@gmail.com

ISSUE DATE	5.27.2025
REVISED	
REVISED	—
REVISED	—

AS-BUILT
PLANS

A2.0