



THE SANDS FILING NO. 1
PRELIMINARY UTILITY AND PUBLIC FACILITY PLAN
 NOVEMBER 2018

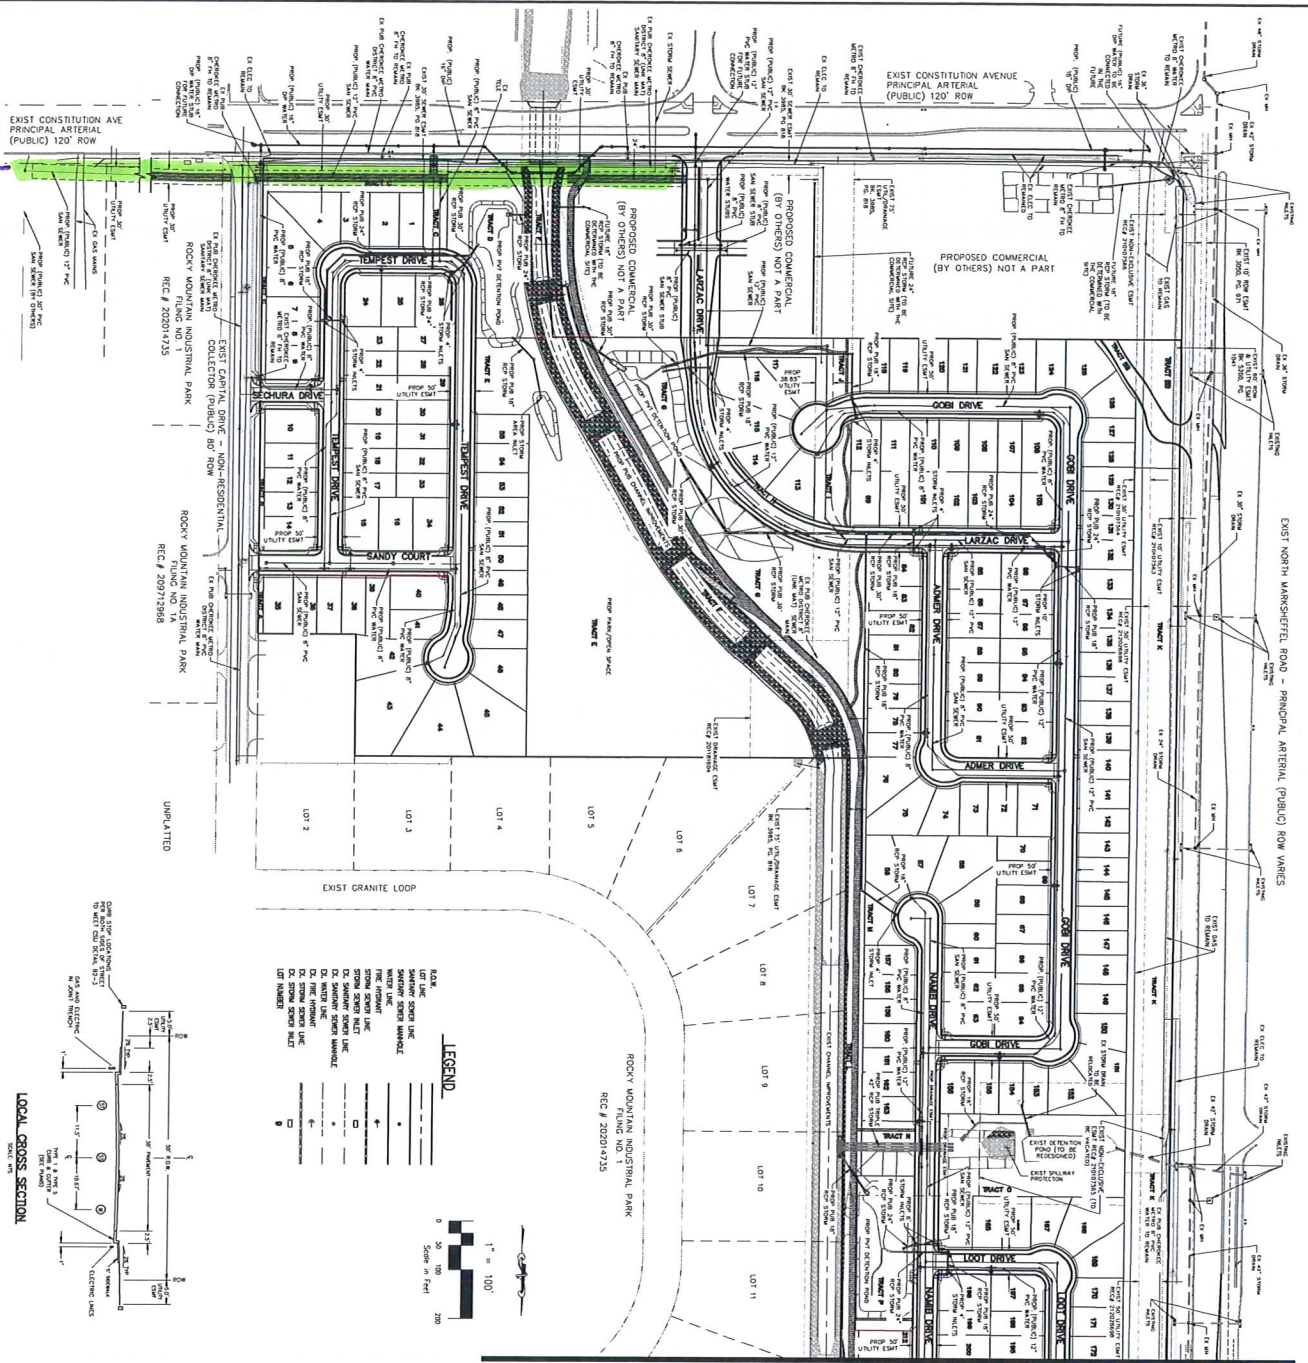

SEE SHEET PUT2

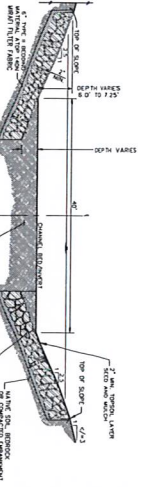


GENERAL NOTES FOR ALL PRELIMINARY UTILITY PLANS

- PROPERTY OWNER'S APPROVAL AND AGREEMENT TO THE FOLLOWING UPON APPROVAL OF PRELIMINARY UTILITY PLAN.
- ALL UTILITIES SHOWN ARE BASED ON THE RECORD DRAWINGS AND FIELD SURVEY DATA. THE UTILITY LOCATIONS, DEPTHS, AND SPACING SHALL BE VERIFIED BY THE UTILITY CONTRACTOR PRIOR TO CONSTRUCTION.
LEGEND

LOCAL CROSS SECTION

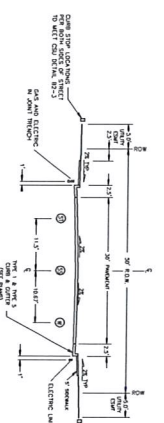

Source line from Sands to Banning Lewis's cutoff east of arrow shown

COLORADO
 PROFESSIONAL ENGINEER
 License No. 12202018
 2/4/2018 PM
 W.SCHULZ

NO.	DATE	DESCRIPTION

PROJECT NO.	43-689	DATE	11-1-18
DESIGNED BY	SLM	SCALE	1"=100'
DRAWN BY	SLM	VER.	N/A
CHECKED BY			

PROJECT NO.	43-689
DATE	11-1-18
SCALE	1"=100'
VER.	N/A

PROJ. A. SANCHEZ, COLORADO P.E. NO. 37160

CIVIL CONSULTANTS, INC.
 2010 E. COLLETT BLVD. SUITE 110
 COLORADO SPRINGS, CO 80903
 PHONE: 719.575.5485

THE SANDS FILING NO. 1
PRELIM UTILITY & PUBLIC FACILITY PLAN

PROJECT NO. 43-689
 SHEET 1 OF 2
 DATE: 11-1-18
 SCALE: 1"=100'
 VER: N/A





THE SANDS FILING NO. 1


PRELIMINARY UTILITY AND PUBLIC FACILITY PLAN

NOVEMBER 2018


SEE SHEET PUT1

SEE ABOVE RIGHT


Water Line from Sands to N. Carefree

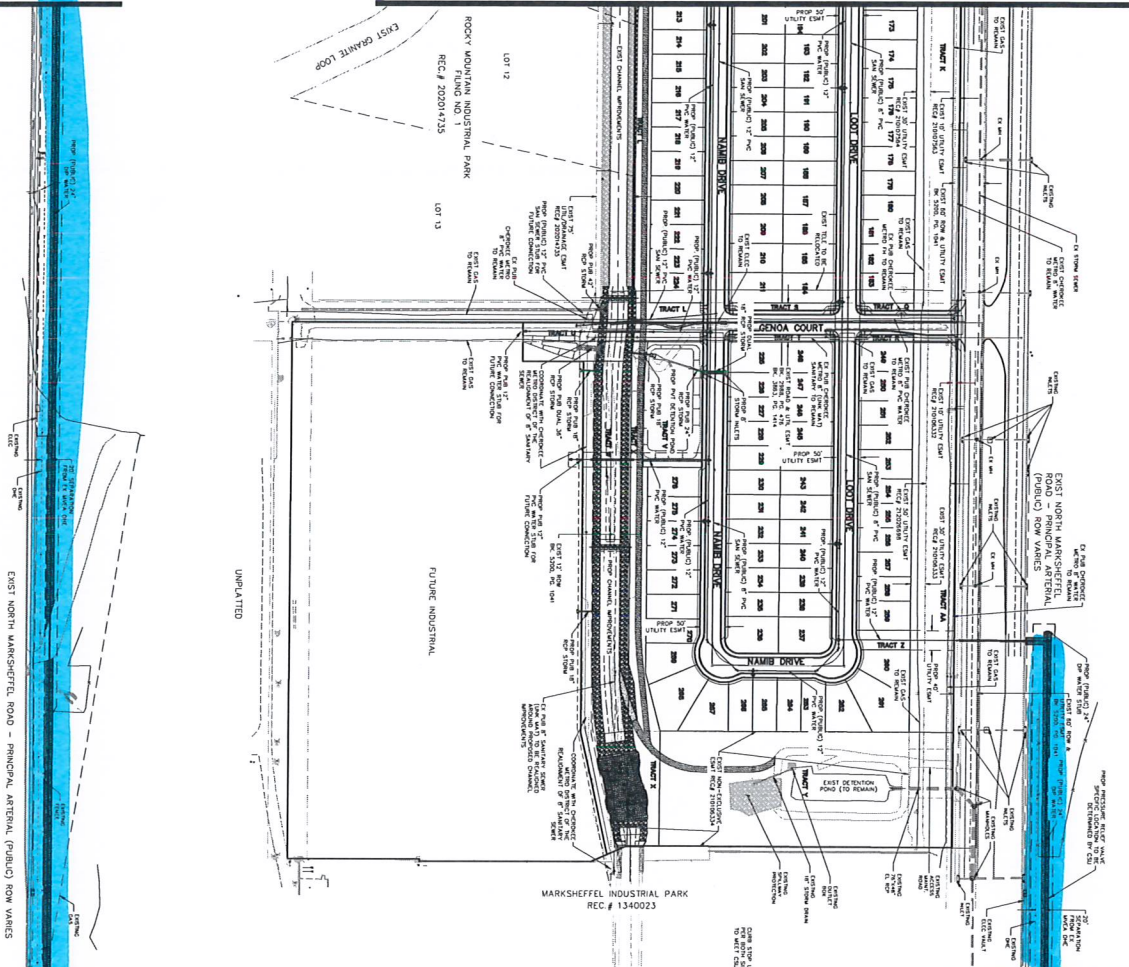


SEE BELOW LEFT

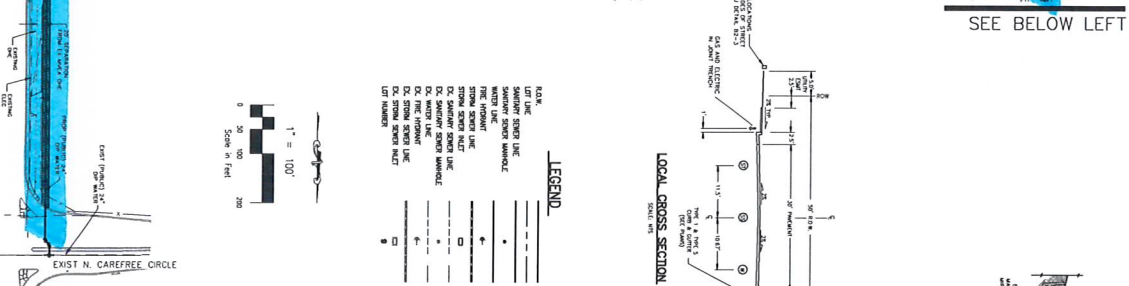

PROPOSED CHANNEL IMPROVEMENT CROSS SECTION

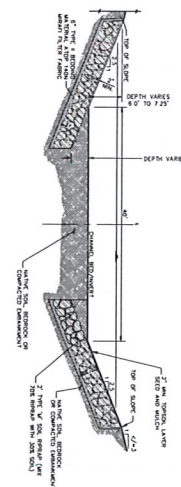

LOCAL CROSS SECTION

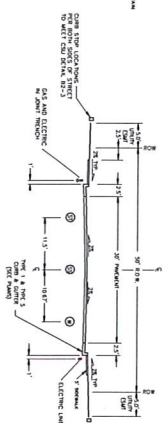

LEGEND

- 1. LOT LINE
- 2. SANITARY SEWER LINE
- 3. WATER LINE

GENERAL NOTES FOR ALL PRELIMINARY UTILITY PLANS

- PROPERTY OWNER(S) ACKNOWLEDGE AND AGREE TO THE FOLLOWING UPON APPROVAL OF PRELIMINARY UTILITY PLAN:
 1. SHALL MAINTAIN THE EXISTING UTILITY LOCATIONS AND PROTECT THEM FROM DAMAGE OR DISRUPTION.
NO.	REV.	DESCRIPTION



ANDREW M. SCHULTE
 COLORADO PROFESSIONAL ENGINEER
 No. 200390325

WROLA A. SANCHEZ, COLORADO P.E. NO. 57165

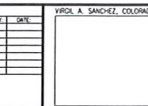

NO. 30-1010 CHECKED: DJE113
 CO.004020 SPRING CO. 8933
 PHONE: 714.743.1945

DESIGNED BY: DJM
 DRAWN BY: JMS
 CHECKED BY: VAS
 SCALE: HORIZ: 1"=100'
 VER: N/A

THE SANDS FILING NO. 1			
PRELIM UTILITY & PUBLIC FACILITY PLAN			
PROJECT NO:	43-085	DATE:	11-1-18
DESIGNED BY:	DJM	SHEET	2 OF 2
DRAWN BY:	JMS	SCALE:	HORIZ: 1"=100'
CHECKED BY:	VAS	VER:	N/A

